



[REDACTED]

5735 47th Avenue • Sacramento, CA 95824
(916) 643-2464
Gerardo Castillo, Chief Business Officer
Kimberly Teague, Contract Specialist

ADDENDUM NO. 1

Date: April 13, 2016


Issued by: Sacramento City Unified School District

Project: AC Paving/Concrete Replacement at Ethel Phillips ES

You are hereby notified of the following changes, clarifications, or modifications to the original Contract Documents, Specifications, and Drawings. This Addendum shall supersede the original attached **Section 01 25 00 – Information for Alternate Proposals – Addendum # 1**, to the contract documents. **New Bid Form (page 24) is attached.**

[REDACTED]

ITEM # 1.5 Sheet A100 – Site Demolition Plan:

- A. Change Note .13 to read: “CONTRACTOR SHALL BE RESPONSIBLE TO SALVAGE, REMOVE, AND RELOCATE STORAGE SHEDS DURING CONSTRUCTION, AND REINSTALL SHEDS IN THE SAME LOCATION PER DISTRICT REQUEST AFTER AC PAVING IS
- 
-
- B. At the 12'-0" tall fence immediately next to the existing adjacent building, at the East end of the site, change the three Keyed Notes indicating .07 to indicate Keyed Note .19. This portion of the fence will be demolished completely, and will not be reinstalled. The 12'-0" tall fence should return and terminate at the neighboring building. See revised Sheet ADD-1 A101 for additional information.
- C. **ADD1-A2 – Partial Site Demolition Plan**, is a partial view of the site demolition plan, clarifying extensive demolition on the 12'-0" tall fence at the SE corner of the site. Please replace this portion of the site demolition plan with this partial plan view and associated keyed notes.

ITEM # 1.6 : Replace this sheet with the attached Sheet
ADD1-A101.

ITEM # 1.7 Detail ADD1-A1 – Wheel Stop Detail: Add attached detail **ADD1-A1** to the contract documents.


END OF ADDENDUM NO. 1

SECTION 401 25.00 – INFORMATION FOR ALTERNATE PROPOSALS – ADDENDUM # 1

1.1 DESCRIPTION

1.1.1 Work included: Provide alternative bid proposal as described in this section:

ADDITIVE ALTERNATE # 1: PAVING LOT SERVING AC SHOWN ON SHEET

 

ADD (written amount) Dollars (\$

**ADDITIVE ALTERNATE # 2: PRECAST WHEEL STOPS, AS SHOWN ON SHEET
ADD-1 A101.**

ADD (written amount) Dollars (\$_____.)

Additive Alternates:


Additive Alternate #1

Dollars \$

PARKING LOT STRIPING AS SHOWN ON SHEET ADD-1 A101

Additive Alternate #2


Dollars \$

 


Descriptions of alternates are primarily scope definitions and do not necessarily detail the full range of materials and processes needed to complete the construction



55. The undersigned has reviewed the Work outlined in the Contract Documents and fully understands the scope of Work required in this Proposal, understands the construction and project management function(s) is described in the Contract Documents, and that each Bidder who is awarded a contract shall be in fact a prime contractor, not a subcontractor, to

 

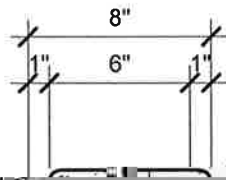

4'-0" LONG PRECAST
CONCRETE WHEEL STOP.

1/2" x 24" LONG GALV. BAR.
DRILL AND SET 1/2" BELOW
TOP OF STOP. (2) PER STOP
FINISH PAVING.

1 **W H L S T O P D T A L**
1 1/2" = 1'-0"

ETHEL PHILLIPS ELEMENTARY SCHOOL
ERP PROJECTS
PAVING REPAIR
SACRAMENTO CITY UNIFIED SCHOOL DISTRICT

UNIT: SHT OF SHTS.

JOB NO DATE:
APP 12 2016

DRAWN BY DRAWING NO:

CHECKED


















APR 12 2016

ST

ADD 01-
01



1 A TIAL SIT D MOL T O PLA
1/16" = 1'-0"

KEY NOTES

- DEMO (E) CHAIN LINK FENCING, INCLUDING ALL POSTS AND FOOTINGS. MAINTAIN END POST WHERE FENCE IS TO REMAIN / RECONNECT.
- REMOVE CHAIN LINK FENCE FABRIC. FENCE POSTS AND FOOTINGS TO REMAIN.

ETHEL PHILLIPS ELEMENTARY SCHOOL
ERP PROJECTS
PAVING REPAIR
 SACRAMENTO CITY UNIFIED SCHOOL DISTRICT

UNIT: SHT OF SHTS.
 JOB NO. DATE:
 DRAWING NO: